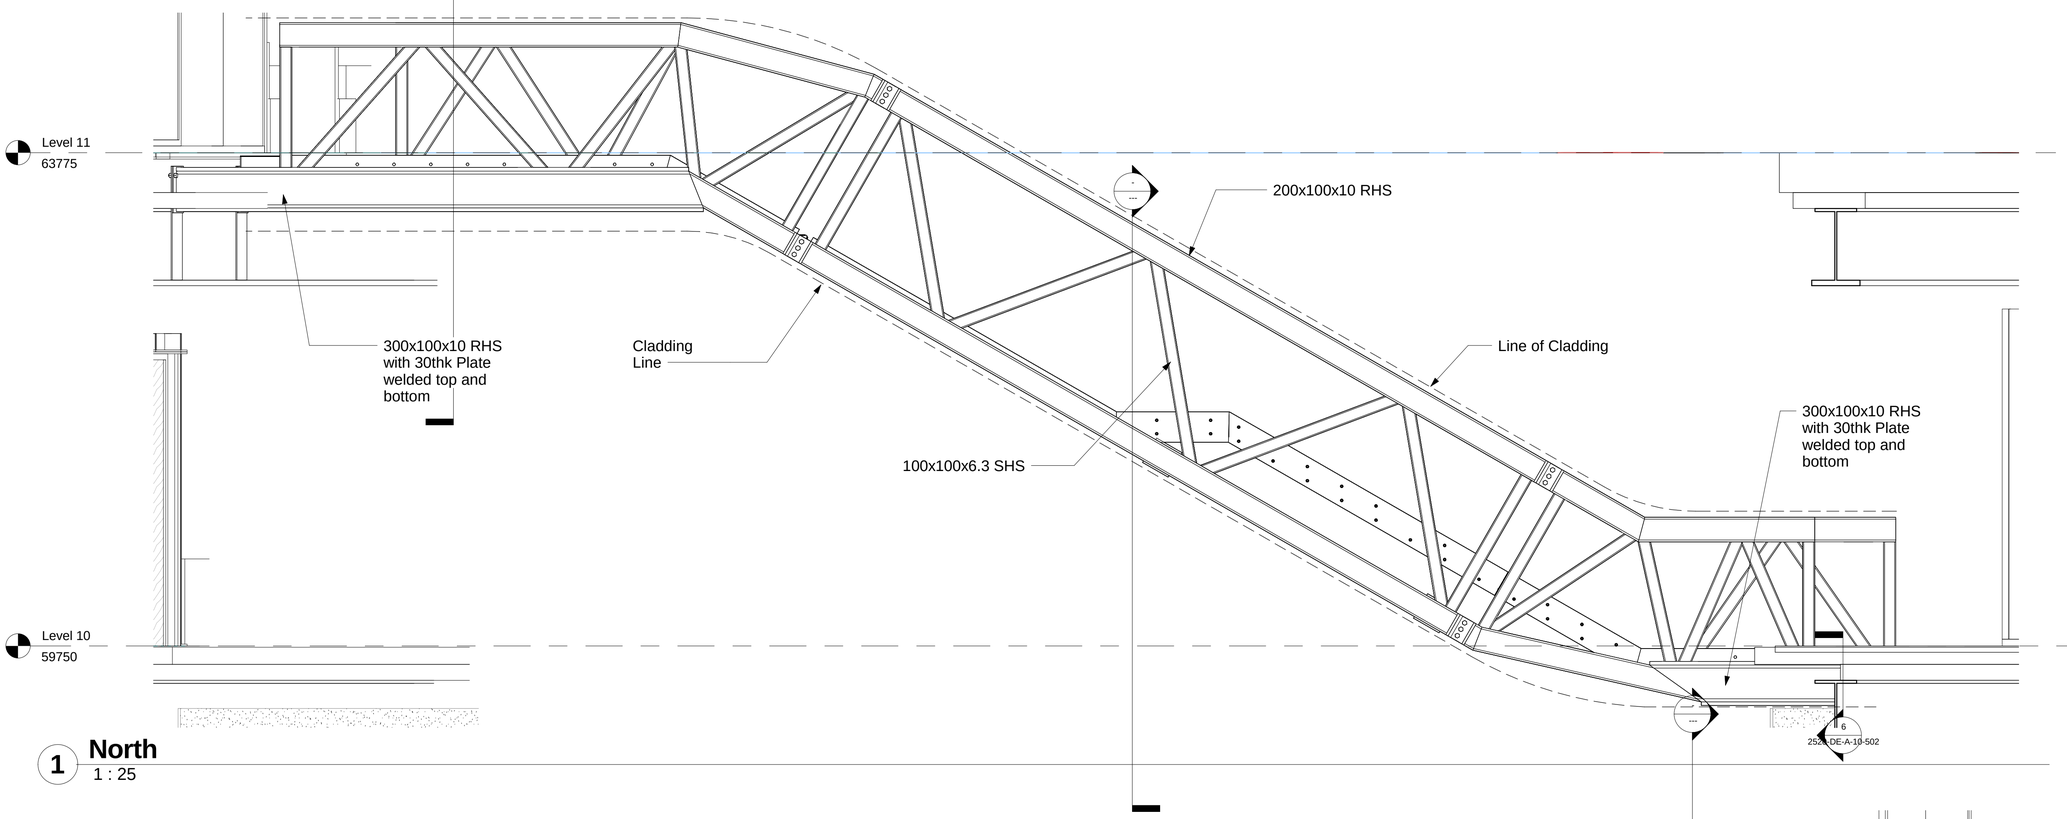

1 **North**
1 : 25

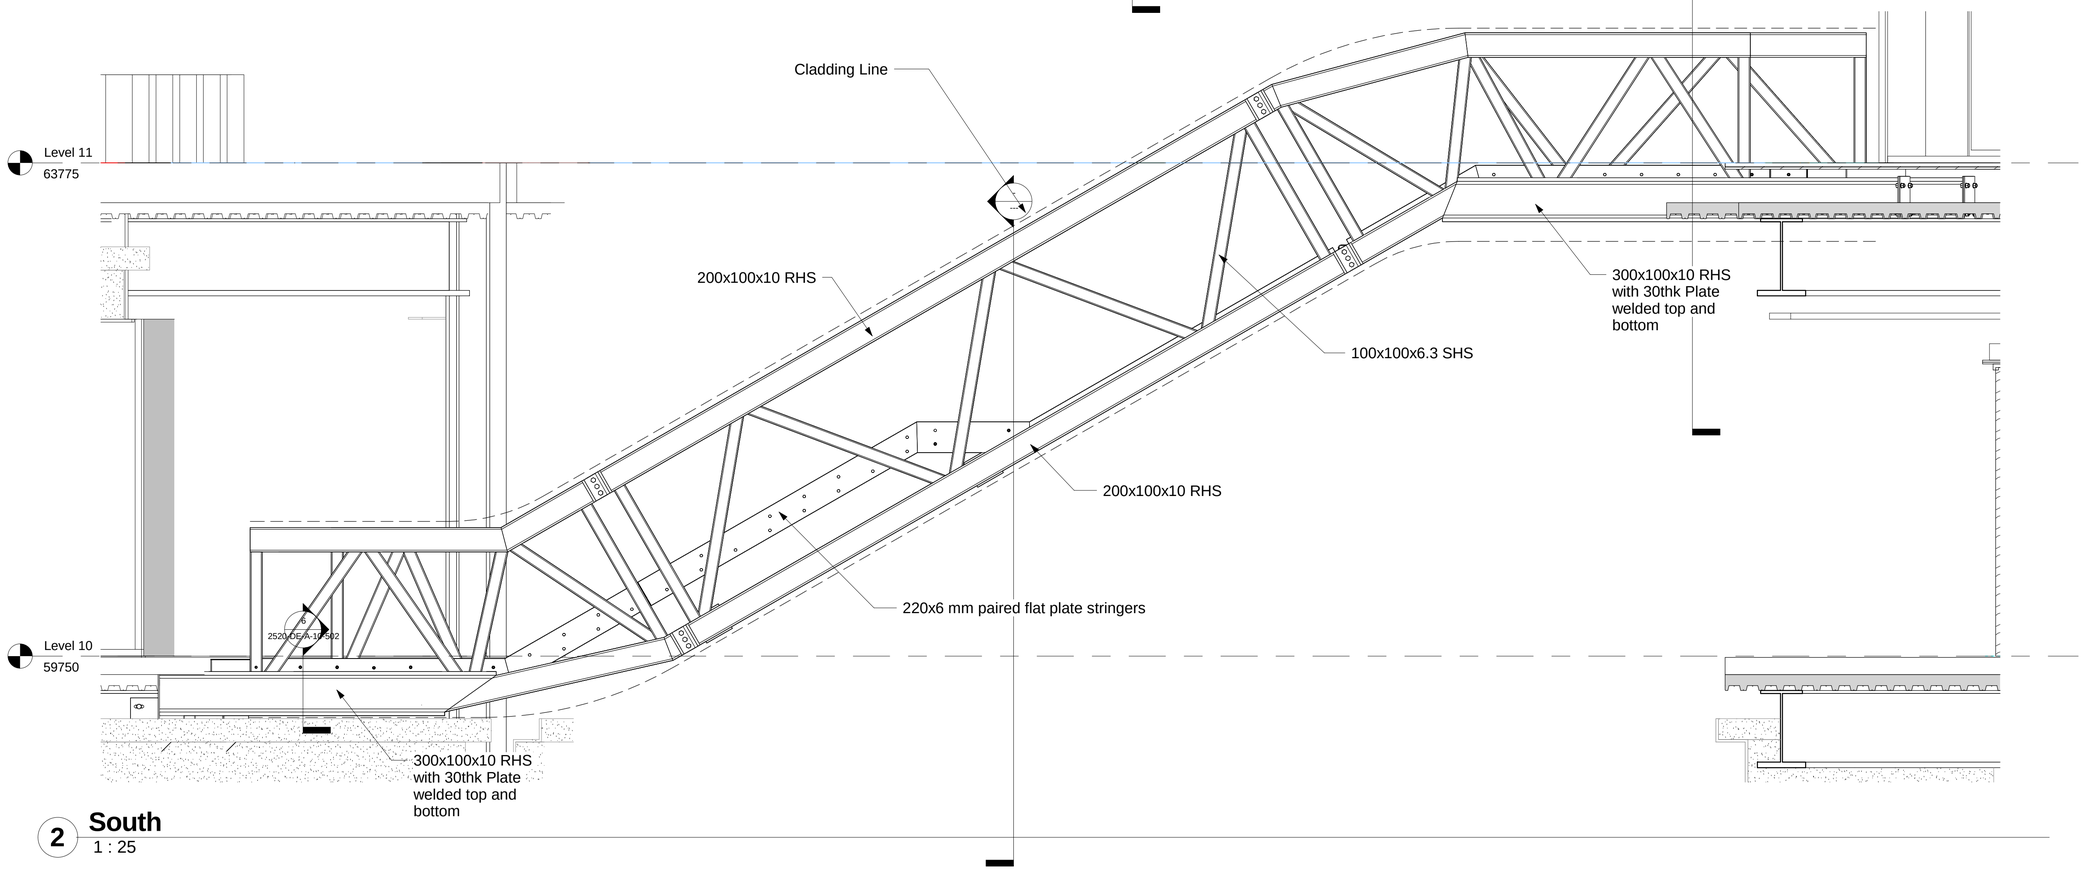

2 **South**
1 : 25

Note: All structural elements will be hidden by blackened steel cladding, timber balustrade or stair treads.

Rev	Description	Date
RD	Updated to Record Drawing	09/05/16

STATUS | PURPOSE OF ISSUE

JOHN DESMOND LIMITED
58 Weir Road
Wimbledon
London
SW19 8UG
TEL: 0208 946 8295
FAX: 0208 947 9407

PROJECT
6 Pancras Square

TITLE
Stair 5 Elevations

CLIENT
ISG

DRAWN BY	CHECKED BY	DATE
AP	RW	15/09/15

SCALE (@ A1)	PROJECT NUMBER
1 : 25	2520

DRAWING NUMBER	REV
2520-EL-A-10-516	RD

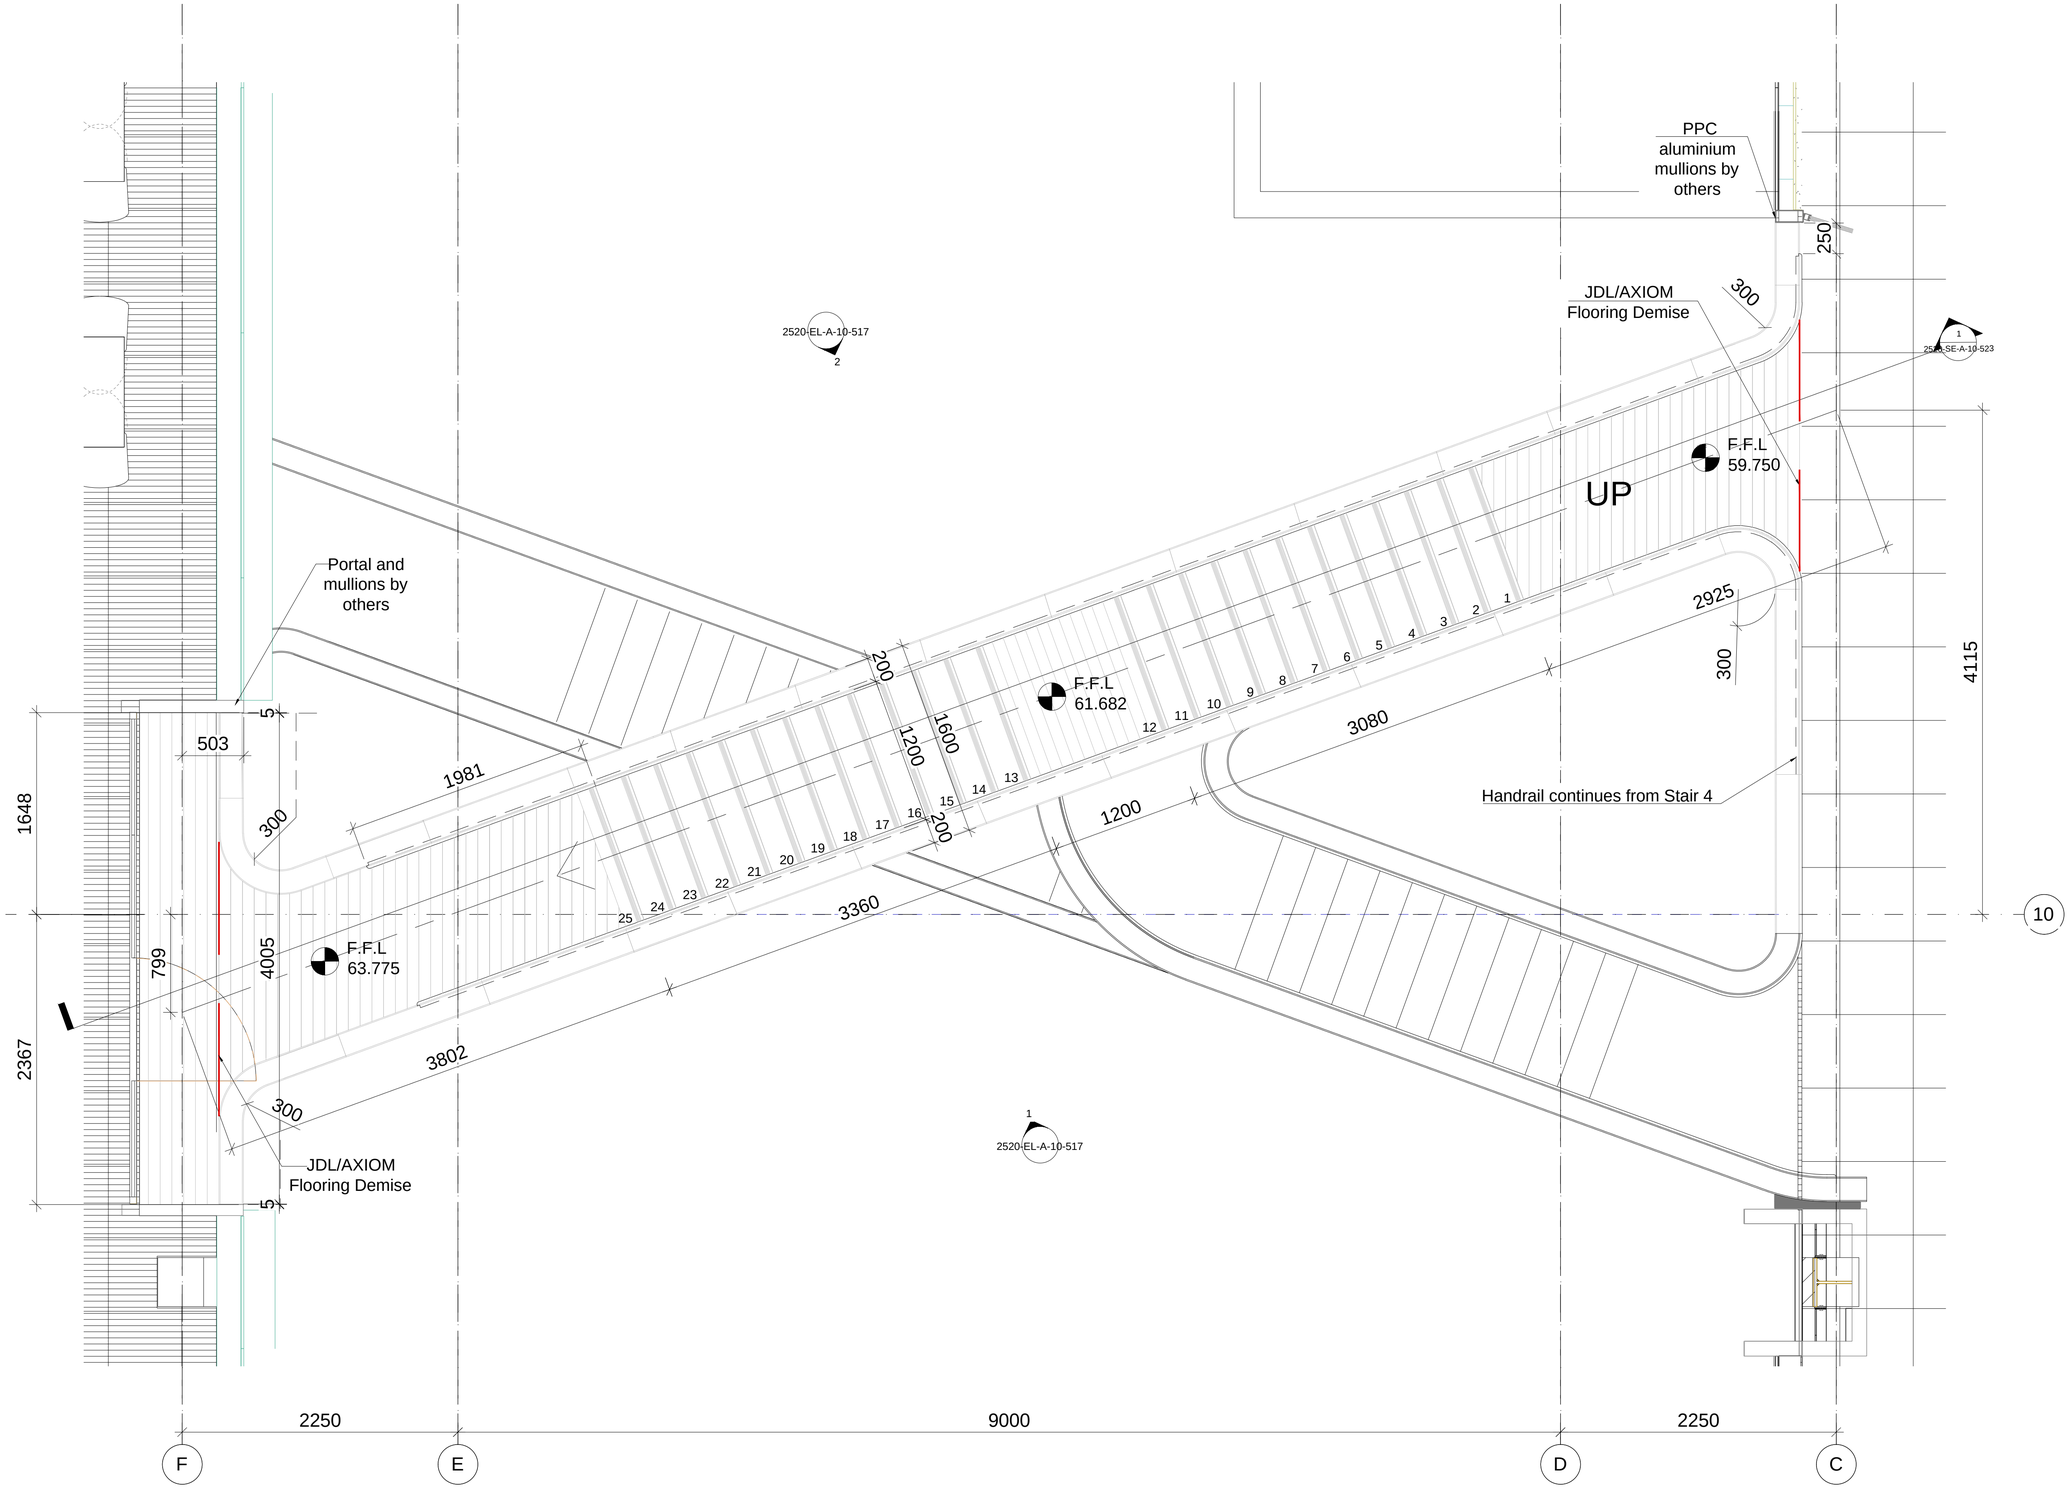

1 Architectural Plan

1 : 25

Rev	Description	Date
01	Updated to architects comments	22/01/16
RD	Updated to Record Drawing	09/05/16

STATUS

PURPOSE OF ISSUE

JOHN DESMOND LIMITED
58 Weir Road
Wimbledon
London
SW19 8UG
TEL: 0208 946 8295
FAX: 0208 947 9407

PROJECT

6 Pancras Square

TITLE

Stair 5 Architectural Plan

CLIENT

ISG

DRAWN BY	CHECKED BY	DATE
AP	RW	19/10/2015

SCALE (@ A1)	PROJECT NUMBER
1 : 25	2520

DRAWING NUMBER	REV
2520-GA-A-10-512	RD

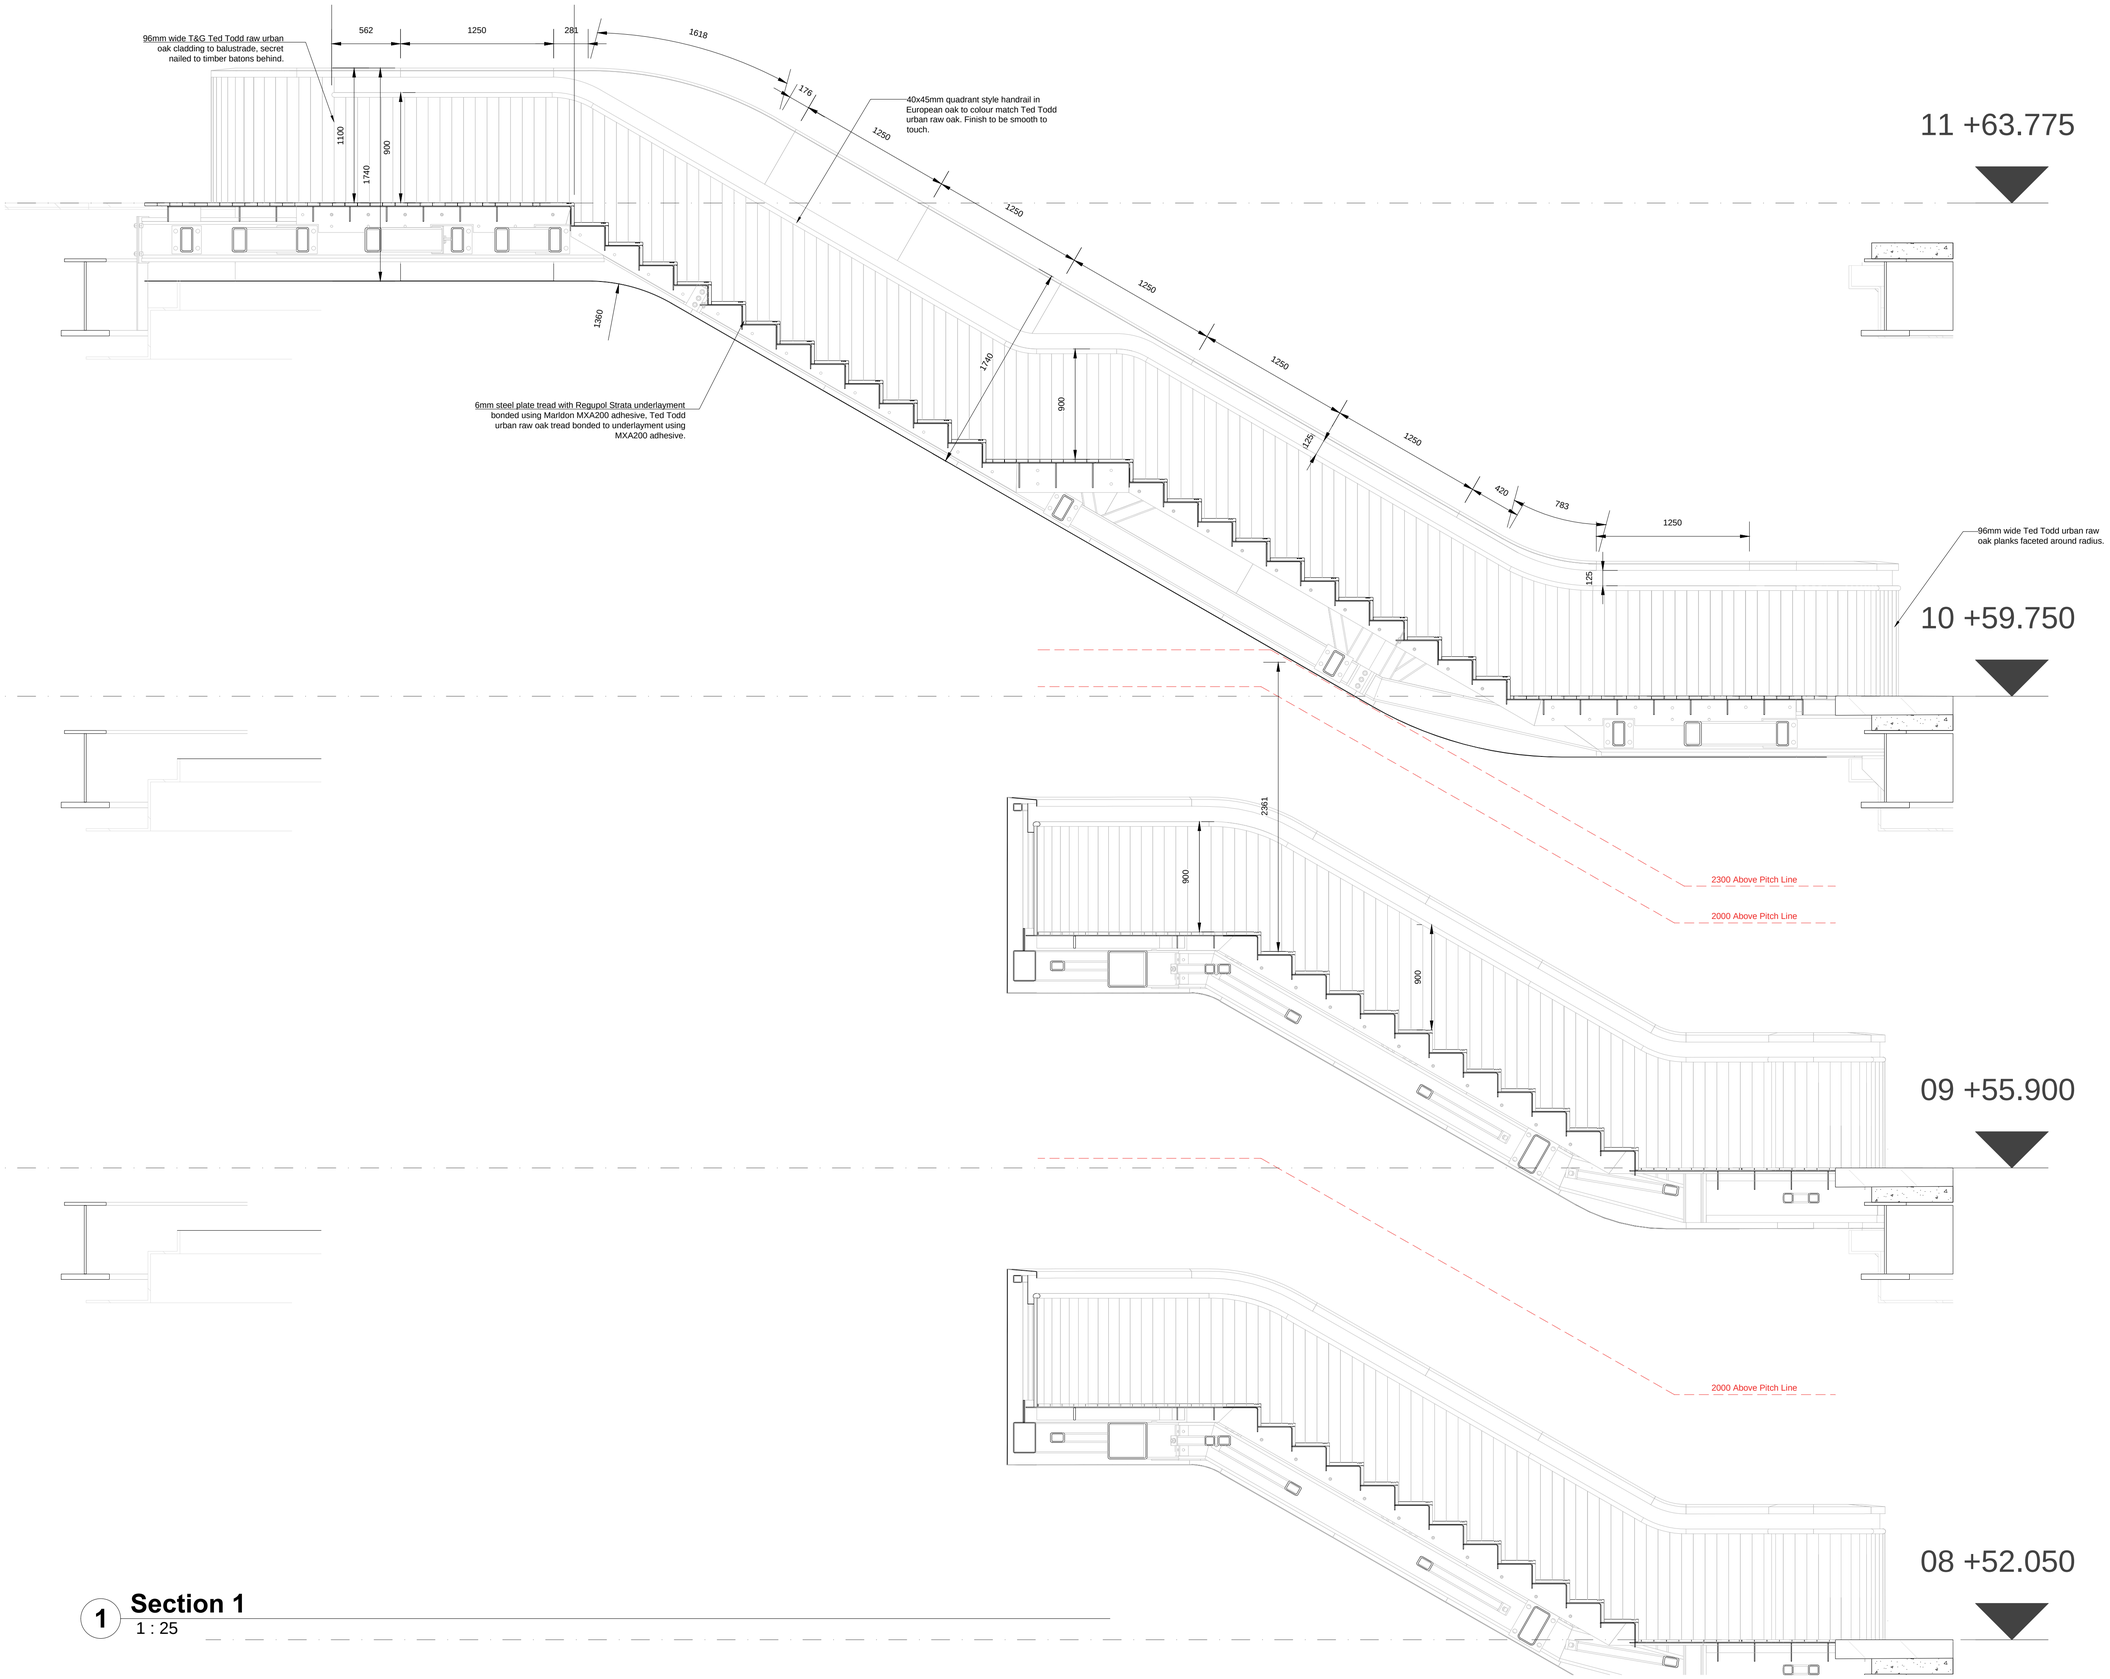

1 **Section 1**
1 : 25

Rev	Description	Date
01	Updated to architects comments	22/01/16
RD	Updated to Record Drawing	09/05/16

STATUS | PURPOSE OF ISSUE

JOHN DESMOND LIMITED
58 Weir Road
Wimbledon
London
SW19 8UG
TEL: 0208 946 8295
FAX: 0208 947 9407

PROJECT
6 Pancras Square

TITLE
Stair 5 Long Section

CLIENT
ISG

DRAWN BY	CHECKED BY	DATE
AP	RW	28/09/15

SCALE (@ A1)	PROJECT NUMBER
1 : 25	2520

DRAWING NUMBER	REV
2520-SE-A-10-523	RD